

**Morris-Shea Bridge Company**  
 DeWaal Pile Installation Record  
 Job 1282, FLNG-PTF — Freeport TX for  
 Pile **6092-323**, 7/27/2015, 18" x 97.17' DWP  
 Rig **DR124**, Pile Type 1, Pump **P-221**

**MORRIS-SHEA**  
BRIDGE COMPANY, INC.

**INSPECTOR DATA**

WEATHER: 98 Sunny

CAGE SPECS

VERTICAL REINFORCEMENT							REBAR PROJECTION			
COLOR	DIA-METER	PERIMETER NO	SIZE	CENTER BAR NO	SIZE	CAGE LENGTH	SPIRAL B	SPIRAL C	D	E
Blue	18	8	6	18	11	15' 0"	6' 0" #3 @ 7" Pitch	8' 0" #3 @ 12" Pitch	1' 7"	1' 7"

TIME LOG

START <b>1:54pm</b>	END <b>2:15pm</b>	TOTAL <b>0:21:00</b>	
DRILL		PUMP	CAGE
START	STOP	START	STOP
1:54pm	2:00pm	2:01pm	2:06pm
	0:06:54		0:05:14
			0:08:40

STROKES	DEPTH	CAGE TYPE
158	-97	PTF 1

Pile 6092-323, Installed 7/27/2015  
 Meets Project Requirements  
 with No Exceptions Noted.

FUGRO INSPECTOR



Johnny Gasaway

**CONSTRUCTION DETAILS**

DESIGN VS. AS BUILT

	DESIGN	AS BUILT	DELTA
EASTING	2796	2795.992	.008
NORTHING	3040	3040.018	.018
TOP OF STEEL	4.917	4.91	.007


CONCRETE

SLUMP

TICKET	MIX	INITIAL	FINAL	CYLINDER
2891636	CD-9342	X	X	X
2891722	CD-9342	X	X	X

**DRILL DATA**

Depth and Strokes (0:12:44)

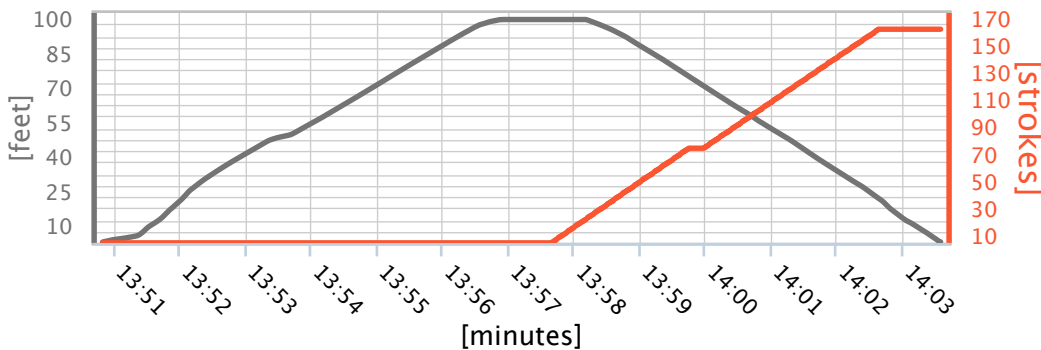

Depth Scale (97.17 ft.)

